

733 THIRD AVENUE

PARTIAL FLOOR 17
3,711 SF



PERIMETER PRIVATE OFFICE



OPEN WORK AREA


AVAILABILITY

- Built Space
- Direct Elevator Presence

PROPERTY FEATURES

- New window and perimeter induction units to promote tenant comfort and energy efficiency
- Green roofs and exclusive outdoor terraces
- LEED GOLD certified under LEED v4 Existing Building: Operations and Maintenance

AS-BUILT PLAN

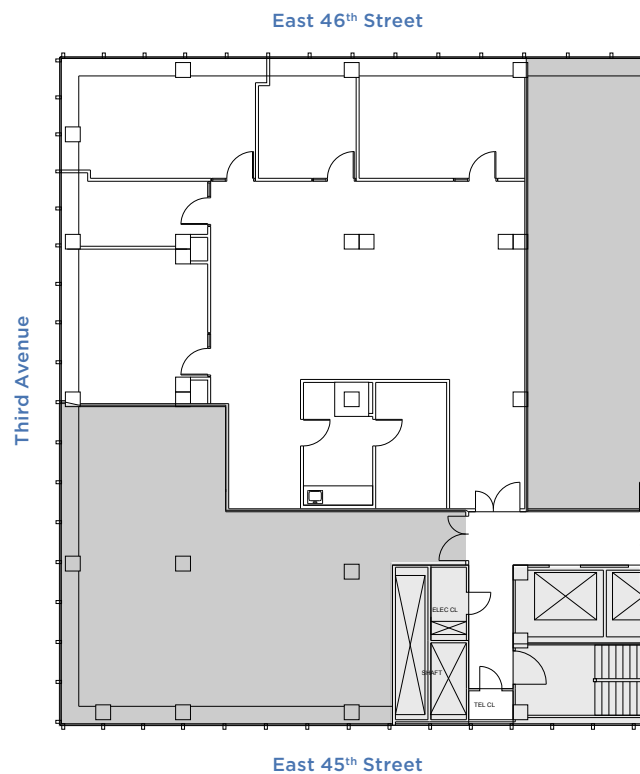

PRIMARY LEASING CONTACT

Ashlea Aaron
212.257.6590
AAaron@durst.org

ADDITIONAL LEASING CONTACTS

Lauren Ferrentino
212.257.6596
LFerrentino@durst.org

Lindsey Ravesloot Cullen
212.257.6518
LRavesloot@durst.org

Bailey Caliban
212.257.6535
BCaliban@durst.org