



PARTIAL FLOOR 24 1,193 SF



BUILDING EXTERIOR



BUILDING LOBBY

AVAILABILITY


- Corner Office
- Great Views

PROPERTY FEATURES

- Building-wide window and perimeter induction unit replacement program completed in 2019
- Green roofs and exclusive outdoor terraces
- Outdoor plaza featuring a zinc green wall
- Renovated lobby
- LEED Silver certified under LEED v4 Existing Buildings: Operations + Maintenance

AS-BUILT PLAN

East 43rd Street

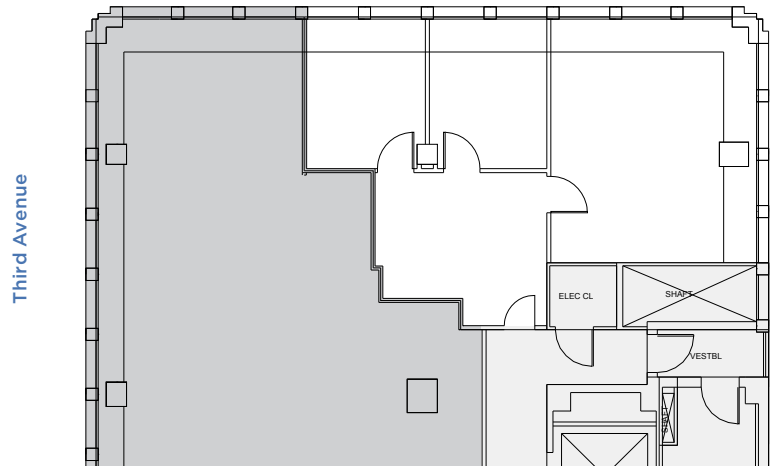

PRIMARY LEASING CONTACT

Ashlea Aaron
212.257.6590
AAaron@durst.org

ADDITIONAL LEASING CONTACTS

Lauren Ferrentino
212.257.6596
LFerrentino@durst.org

Lindsey Ravesloot Cullen
212.257.6518
LRavesloot@durst.org

Bailey Caliban
212.257.6535
BCaliban@durst.org