

# 1133

Avenue of the Americas

## AVAILABILITIES

---

Entire Floor 43	22,456 SF
-----------------	-----------

*Exceptional Midtown and West Side Views.  
Financial Services Buildout. Available March 2022.*

---

Partial Floor 36	5,976 SF
------------------	----------

*Built Space, Corner Unit,  
Excellent Views and Natural Light*

---

Entire Floor 27	
-----------------	--

*Built Spaces. Office and Office/Open Work  
Layouts. Midtown and Westside Views.*

Suite 2700	1,533 SF
Suite 2710-19	4,652 SF
Suite 2720-24	5,263 SF
Suite 2725-29	3,345 SF
Suite 2730-34	2,615 SF
Suite 2735-39	4,188 SF

---


## PROPERTY OVERVIEW

With its limestone façade and sleek modernist lines, 1133 Avenue of the Americas led the transformation of Sixth Avenue into a global business hub. Located between 43<sup>rd</sup> and 44<sup>th</sup> Streets, the tower maintains a distinctive presence overlooking Bryant Park.

A recently completed capital improvement initiative brought a soaring travertine lobby accented by a striking LED sculpture by Leo Villareal, destination dispatch elevator controls, new elevator cab interiors, and a newly landscaped outdoor plaza. Other property features include green roofs and exclusive landscaped terraces for tenants to enjoy. The building is also home to the world headquarters, showroom and performance space of Steinway & Sons.

## MAJOR TENANTS

Bank of America; Patterson, Belknap Webb & Tyler; Chubb; ING Financial Holdings; Take 2 Interactive; Steinway & Sons; and The National Basketball Players Association (NBPA).

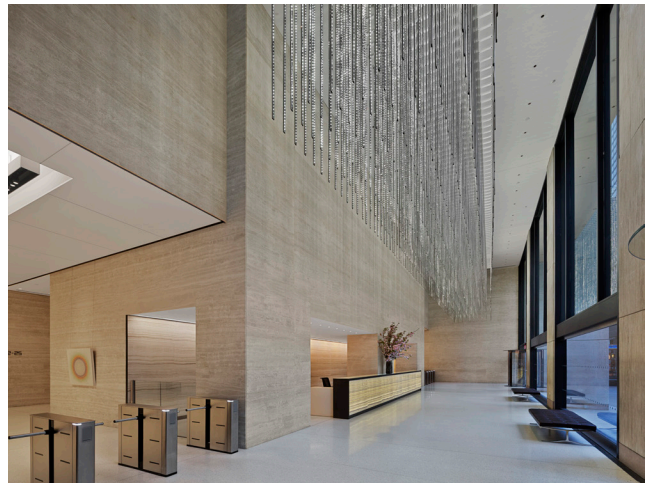

durst.org

### PRIMARY LEASING CONTACT

Rocco Romeo  
212.257.6630  
RRomeo@durst.org

### ADDITIONAL LEASING CONTACTS

Thomas Bow  
212.257.6610  
TBow@durst.org

Tanya Grimaldo  
212.257.6515  
TGrimaldo@durst.org

# 1133

Avenue of the Americas

## PROPERTY FACT SHEET

### OVERVIEW

#### BUILDING OWNER & MANAGER

The Durst Organization

#### YEAR COMPLETED

1970

#### CAPITAL IMPROVEMENTS

In 2016, a \$40 million capital improvement program completed renovations to the soaring travertine lobby, which include: a new security desk, a striking LED sculpture by Leo Villareal, destination dispatch elevator controls and new elevator cab interiors. Other features of the property include over 5,000 square feet of green roofs and exclusive landscaped terraces for tenants to enjoy.

#### ARCHITECT

Emory Roth & Sons

#### LOCATION

1133 Avenue of the Americas between 43<sup>rd</sup> and 44<sup>th</sup> Streets

#### LEASING CONTACTS

Thomas Bow

[tbow@durst.org](mailto:tbow@durst.org), 212.257.6610

Rocco Romeo

[rromeo@durst.org](mailto:rromeo@durst.org), 212.257.6630

Tanya Grimaldo

[tgrimaldo@durst.org](mailto:tgrimaldo@durst.org), 212.257.6515

#### PROXIMITY TO MASS TRANSIT

Adjacent to 15 Subway lines on 42nd Street: 1, 2, 3, 7, A, B, C, D, E, F, M, N, R, Q, S; Blocks from the Port Authority Bus Terminal and Grand Central; 10 minute walk to Penn Station

#### BUILDING HEIGHT

539 feet

#### STORIES

45

#### SLAB TO SLAB HEIGHT

12 feet to 21 feet

#### FLOOR PLATES

Low: 32,000 -35,000 SF

High: 22,000 - 24,000 SF

#### STANDARD HOURS OF OPERATION

The on-site Property Management Office is open 8:30 AM-5:30 PM, Monday-Friday. Building hours are from 8:00 AM- 6:00 PM.

#### DELIVERIES/LOADING DOCK

The loading dock is located at 111 West 43rd Street. Deliveries requiring freight elevator service can be made Monday-Friday during regular freight hours (8:00 AM-5:00 PM, excluding holidays). The loading dock bays measure 11' 4" high and 12' 4" high.

#### ELEVATORS

20 passenger elevators with destination dispatch and modernized cabs Two freight elevators: 70"d x 84"w x 120"h and 79"d x 70"w x 112"h

### SUSTAINABILITY

- LEED Silver certification under LEED v4 Operations + Maintenance: Existing Buildings; one of the first two buildings in NYC to receive certification under the more stringent LEEDv4 rating system
- EPA Water Sense-labeled new plumbing fixtures to promote high-performance and water efficiency
- Tenant recycling program and organics collection program for composting
- Use of green cleaning products, equipment and strategies to promote a healthier work environment
- Renewable wind power is purchased to offset 100% of the building's electricity use
- Green roofs and exclusive outdoor terraces for tenants to enjoy

### POWER AND UTILITIES

#### HEATING, VENTILATION AND AIR CONDITIONING

Heating is provided by boiler systems. The air conditioning system is a high-velocity induction unit system serving the perimeter of the building and a medium velocity variable air-volume system serving the interior areas.

#### ELECTRICAL SYSTEM

Con Edison delivers electrical power to the building via a second contingent, 277/480V, spot network located in the sidewalk vault. The service is made up of the four 3,200-amp service take-offs, which feed the building's service switchgear. Power is distributed via pipe and wire risers throughout the building.

The building's electrical distribution system is continuously maintained in accordance with national testing standards and applicable codes to provide the highest level of reliability. It is equipped with a sophisticated, web-enabled electrical metering system, which is used for tenant billing as well as allowing our in-house experts to monitor system performance in real-time. Our in-house electrical engineers analyze new tenant designs and requirements to ensure that sufficient electrical distribution is provided in accordance with the lease terms and building rules and regulations.

### TELECOMMUNICATIONS

The Durst Organization offers its tenants a wide range of telecommunication providers. Service providers currently available at 1133 Avenue of the Americas:

- Wireless: Verizon Wireless
- Telephone: Verizon
- Internet: Cogent Communication, Lighttower, RCN, and Spectrum
- Television: RCN and Spectrum



#### PRIMARY LEASING CONTACT

Rocco Romeo  
212.257.6630  
[RRomeo@durst.org](mailto:RRomeo@durst.org)

#### ADDITIONAL LEASING CONTACTS

Thomas Bow  
212.257.6610  
[TBow@durst.org](mailto:TBow@durst.org)


Tanya Grimaldo  
212.257.6515  
[TGrimaldo@durst.org](mailto:TGrimaldo@durst.org)

# 1133

Avenue of the Americas

## AS-BUILT PLAN FLOOR 43

West 44<sup>th</sup> Street

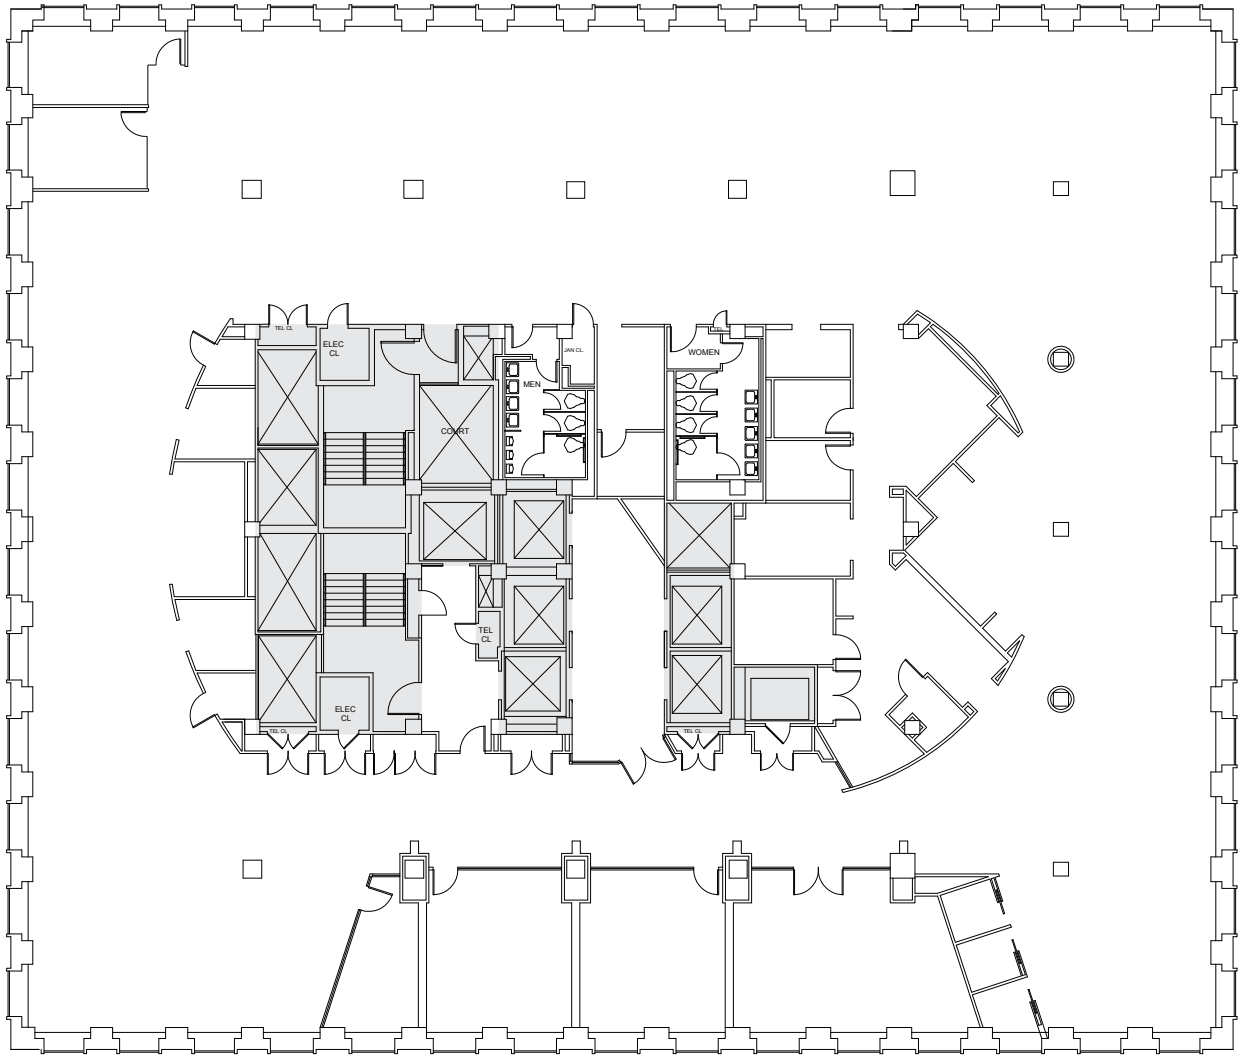

West 43<sup>rd</sup> Street

22,456 SF



#### PRIMARY LEASING CONTACT

Rocco Romeo  
212.257.6630  
RRomeo@durst.org

#### ADDITIONAL LEASING CONTACTS


Thomas Bow  
212.257.6610  
TBow@durst.org

Tanya Grimaldo  
212.257.6515  
TGrimaldo@durst.org

# 1133

Avenue of the Americas

## AS-BUILT PLAN PARTIAL FLOOR 36

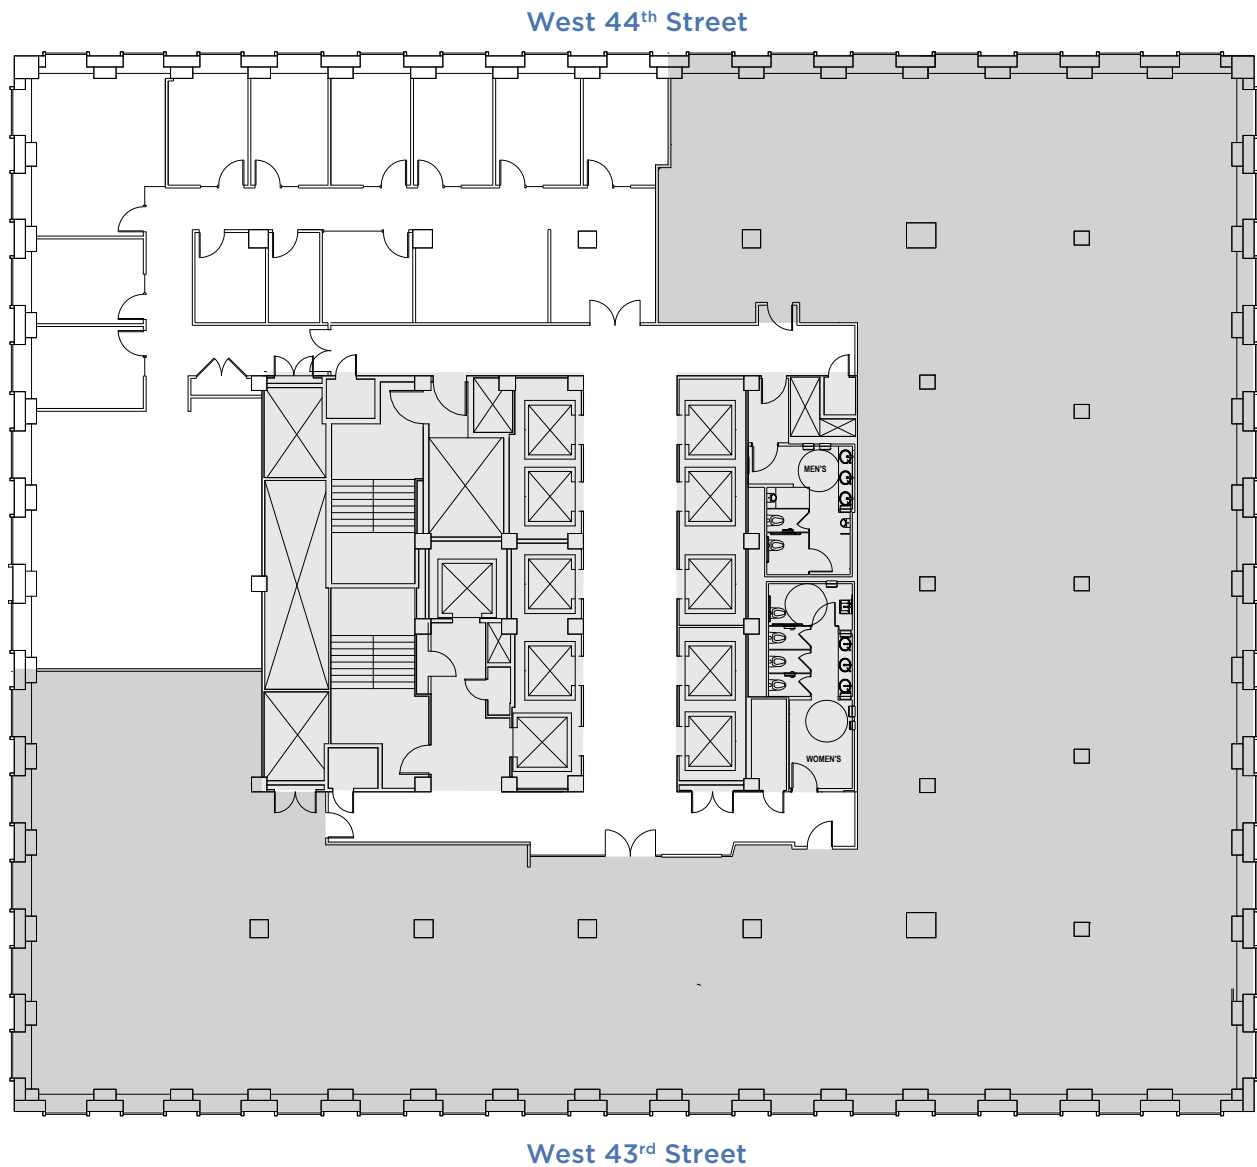

5,976 SF



#### PRIMARY LEASING CONTACT

Rocco Romeo  
212.257.6630  
RRomeo@durst.org

#### ADDITIONAL LEASING CONTACTS


Thomas Bow  
212.257.6610  
TBow@durst.org

Tanya Grimaldo  
212.257.6515  
TGrimaldo@durst.org

# 1133

Avenue of the Americas

## AS-BUILT PLAN ENTIRE FLOOR 27

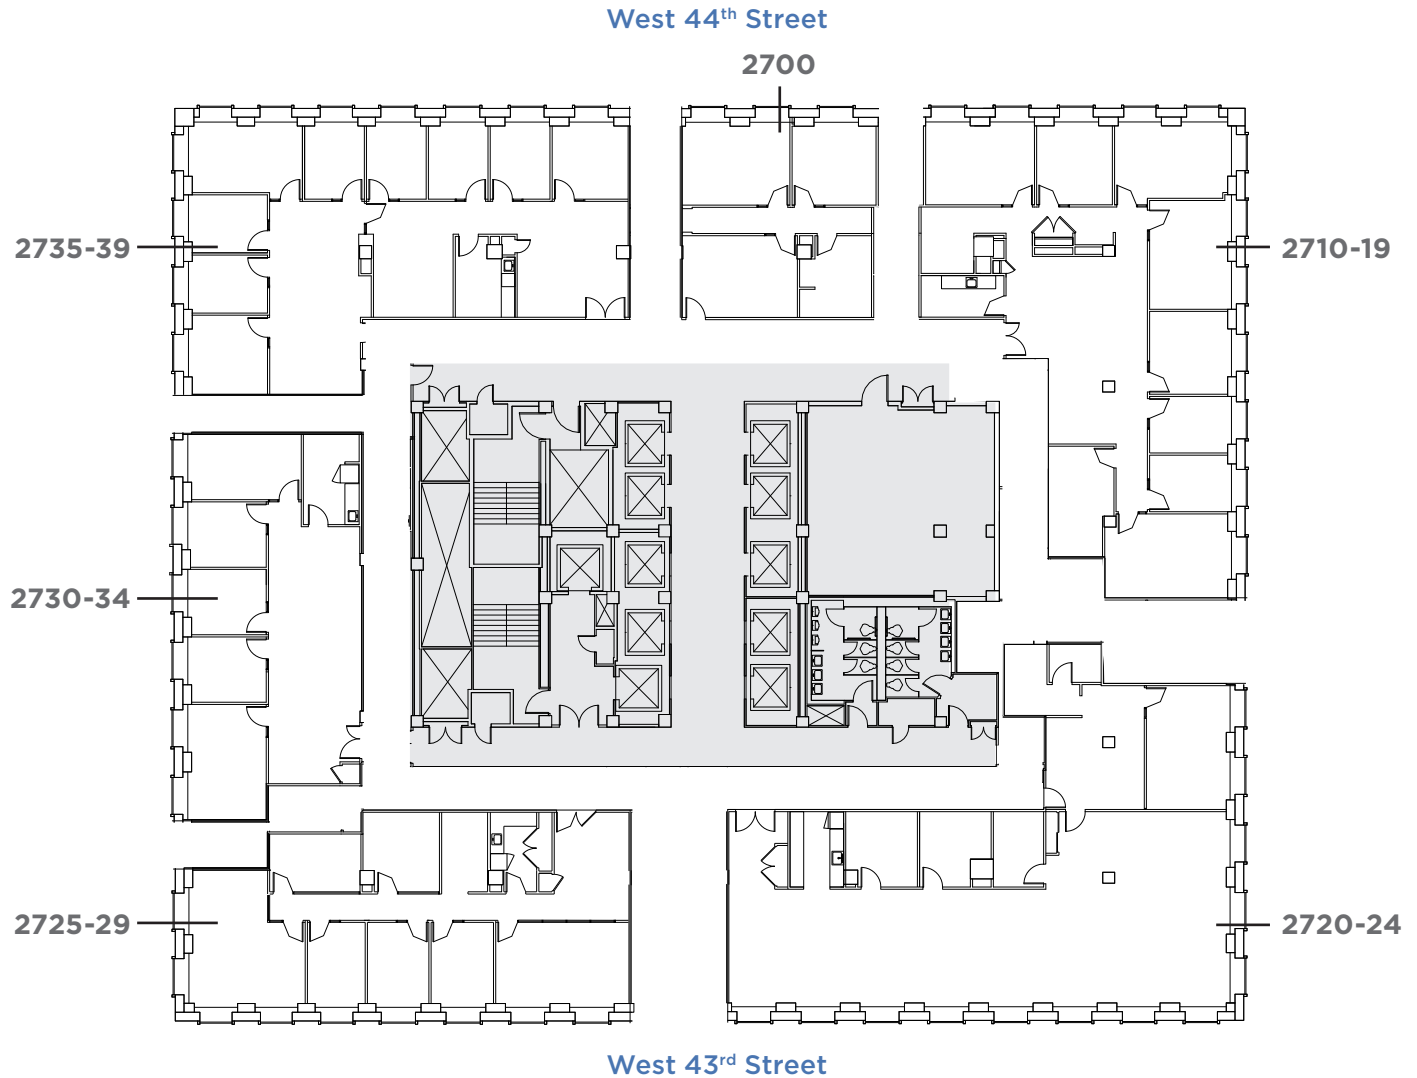

### Suite 2700

1,533 SF

### Suite 2710-19

4,652 SF

### Suite 2720-24

5,263 SF

### Suite 2725-29

3,345 SF

### Suite 2730-34

2,615 SF

### Suite 2735-39

4,188 SF



#### PRIMARY LEASING CONTACT

Rocco Romeo  
212.257.6630  
RRomeo@durst.org

#### ADDITIONAL LEASING CONTACTS

Thomas Bow  
212.257.6610  
TBow@durst.org

Tanya Grimaldo  
212.257.6515  
TGrimaldo@durst.org