

205

EAST 42ND STREET

AVAILABILITIES

Entire Floor 21	7,377 SF
Entire Floor 20	17,004 SF
Entire Floor 19	18,451 SF
Entire Floor 17	19,832 SF
Entire Floor 16	19,832 SF
Entire Floor 15	19,832 SF
Entire Floor 14	19,831 SF
Entire Floor 13	22,264 SF

Full-floor leasehold condo ideal for 501(c)(3) organizations. Pristine, built, and furnished with potential to create accessible outdoor space.

Ground Floor Retail	1,242 SF
---------------------	----------

Upscale café buildout adjacent to lobby and with direct 42nd Street presence.


PROPERTY OVERVIEW

The acquisition of 205 East 42nd Street by Joseph Durst in 1944 signaled the first step in The Durst Organization's monumental transformation of Third Avenue into the highly coveted office submarket it is today. Surrounded by restaurants, hotels, corporate headquarters, and countless transit options, this stately 1927 brick-clad Class A office property recently underwent extensive capital improvements to even better serve its diverse tenant base.

Located a mere block from Grand Central Terminal, 205 East 42nd Street most notably features a masterfully restored Art Deco lobby, new windows, new life safety systems, 3,625 SF of green roofs, and tenant terrace opportunities punctuated by sweeping Midtown East views.

MAJOR TENANTS

CUNY; Fedcap Rehabilitation Services; Residential Management Group; and United Way of New York City

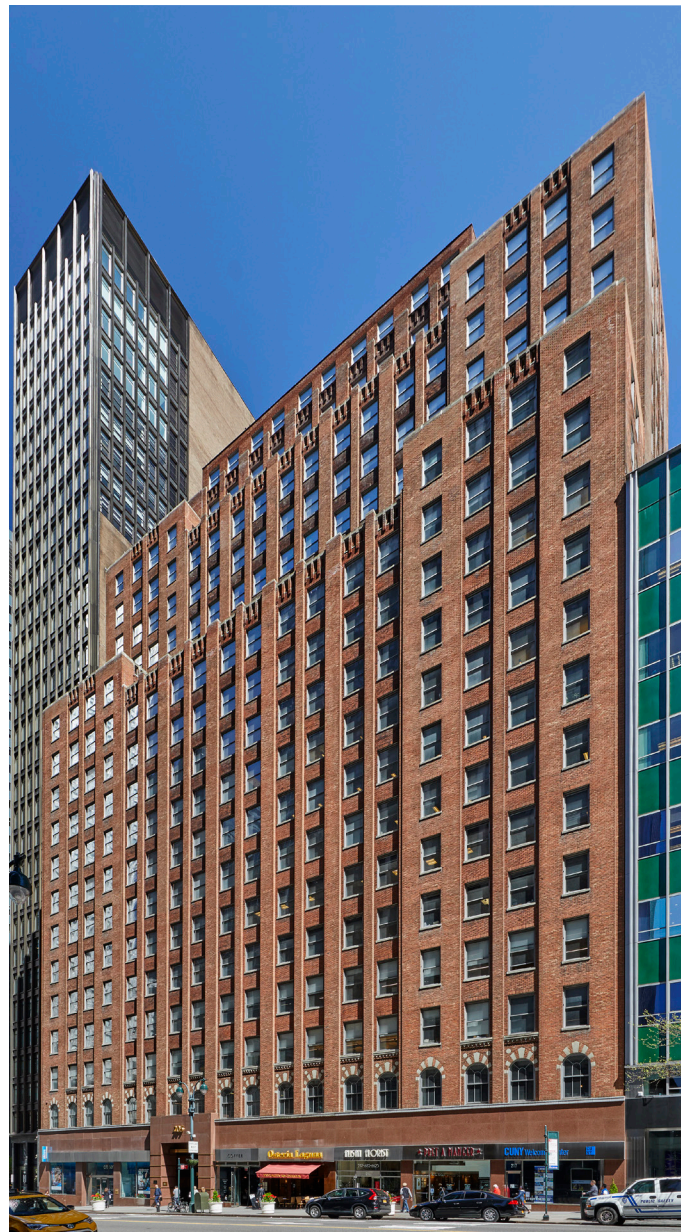

PRIMARY LEASING CONTACT

Lauren Ferrentino
212.257.6596
LFerrentino@durst.org

ADDITIONAL LEASING CONTACTS

Tanya Grimaldo
212.257.6515
TGrimaldo@durst.org

Thomas Bow
212.257.6610
TBow@durst.org

PROPERTY FACT SHEET

OVERVIEW

BUILDING OWNER & MANAGER

The Durst Organization

YEAR COMPLETED

1927 (acquired by The Durst Organization in 1944)

CAPITAL IMPROVEMENT

A \$15 million renovation was completed in 2013. Updates included modernized elevators, MEP and BMS upgrades, as well as a restoration of the art deco lobby.

ARCHITECT

Starrett and Van Vleck

LOCATION

North side of East 42nd Street between Third and Second Avenues.

LEASING CONTACTS

Lauren Ferrentino

LFerrentino@durst.org, 212.257.6596

Tanya Grimaldo

TGrimaldo@durst.org, 212.257.6515

Thomas Bow

TBow@durst.org, 212.257.6610

PROXIMITY TO MASS TRANSIT

Grand Central Terminal: 4, 5, 6, 7, E, and S subways. Metro North trains; M42, M101, M102, M103, M15, SBS busses

BUILDING HEIGHT

253 feet

STORIES

21

SLAB TO SLAB HEIGHT

11 feet, 4 inches

FLOOR PLATES (LOW/HIGH)

Reinforced cast-in-place concrete

Low: 27,500 SF - 31,200 SF

High: 17,000 SF - 27,500 SF

TENANT ACCESS

Security for the building is provided by electronic security systems, proximity cards for building access control and CCTV. The lobby is staffed 24/7 by either a licensed security guard and/or a building staff member. All Durst buildings are centrally monitored by Durst's Security Command Center, which is staffed 24/7 by licensed security personnel.

STANDARD HOURS OF OPERATION

The on-site property management office is open 8:30 AM to 5:30 PM, Monday through Friday. Building hours are 8:00 AM to 6:00 PM, Monday through Friday.

ELEVATORS

10 modernized passenger elevators
Two freight elevators

FREIGHT ELEVATORS

#12 freight elevator serves loading dock, basement, and floors 2-10
(6'8" deep x 6" wide x 8'8" high)

DELIVERIES/LOADING DOCK

The loading dock is located at 208 East 43rd Street. Freight hours are Monday through Friday, 9:00 AM to 12:00 PM and 1:00 PM to 5:00 PM. The loading dock is 5' wide x 6'5" deep x 7'2" high. Any delivery requiring more than two trips is considered a bulk delivery and must be scheduled before or after normal building hours. The loading dock is staffed by security personnel while in operation.

SUSTAINABILITY

- EPA Water Sense-labeled new plumbing fixtures promote water efficiency
- LEED Gold certified under the LEED v4 Existing Buildings: Operation and Maintenance
- Tenant recycling program and organics collection program for composting
- Use of green cleaning products, equipment, and strategies to promote a healthier work environment
- Renewable wind power is purchased to offset 100% of the building's electricity use
- Green roofs and exclusive outdoor terraces

POWER AND UTILITIES

HVAC

Heating is provided by Con Edison steam. Heat exchangers convert the steam to hot water, which is supplied to coils in the central fan rooms and perimeter induction units. Perimeter heat is supplied by steam radiation. Air conditioning is provided by a chilled water system with individual floor air-handling units. Three steam turbine refrigeration machines have a total capacity of 1,150 tons. The cooling towers have a total capacity of 1,500 tons, of which 500 tons are available for tenants' supplementary cooling systems. Temperatures for the perimeter and interior zones are controlled by thermostats.

ELECTRICAL SYSTEM

Con Edison delivers electrical power to the building via a second contingent, 120/208V, spot network located in the sidewalk vault. The service comprises of three 4,000-amp service take-offs, which feed the building's service switchgear and is shared with the adjacent building, 675 Third Avenue (also owned and operated by The Durst Organization). Power is then distributed via pipe and wire risers throughout the building. 100% of the energy utilized by the building is supplied by wind power purchased from a third-party energy supplier.

The building's electrical distribution system is continuously maintained in accordance with national testing standards and applicable codes to provide the highest level of reliability. It is equipped with a sophisticated, web-enabled electrical metering system used for tenant billing as well as in-house monitoring. In-house electrical engineers analyze new tenant designs and requirements to ensure sufficient electrical distribution is provided in accordance with lease terms and building rules and regulations.

TELECOMMUNICATIONS

The Durst Organization offers its tenants a wide range of telecommunications providers. Service providers currently available at 205 East 42nd Street are:

- Wireless: AT&T and Verizon Wireless
- Telephone: Verizon
- Internet: Cogent Communication, Lighttower, RCN, and Spectrum
- Television: RCN and Spectrum

PRIMARY LEASING CONTACT

Lauren Ferrentino
212.257.6596
LFerrentino@durst.org

ADDITIONAL LEASING CONTACTS

Tanya Grimaldo
212.257.6515
TGrimaldo@durst.org

Thomas Bow
212.257.6610
TBow@durst.org

205
EAST 42ND
STREET

PROPERTY HIGHLIGHTS

13TH FLOOR TERRACE



PRIMARY LEASING CONTACT

Lauren Ferrentino
212.257.6596
LFerrentino@durst.org

ADDITIONAL LEASING CONTACTS

Tanya Grimaldo
212.257.6515
TGrimaldo@durst.org

Thomas Bow
212.257.6610
TBow@durst.org

AS-BUILT PLAN
ENTIRE FLOOR 21



7,377 SF

Existing Outdoor Space: 3,187 SF

PRIMARY LEASING CONTACT

Lauren Ferrentino
212.257.6596
LFerrentino@durst.org

ADDITIONAL LEASING CONTACTS

Tanya Grimaldo
212.257.6515
TGrimaldo@durst.org

Thomas Bow
212.257.6610
TBow@durst.org

AS-BUILT PLAN
ENTIRE FLOOR 20



17,004 SF

Potential Outdoor Space: 1,044 SF

TDO is currently conducting studies to determine location and feasibility of converting setbacks to active terraces.

PRIMARY LEASING CONTACT

Lauren Ferrentino
212.257.6596
LFerrentino@durst.org

ADDITIONAL LEASING CONTACTS

Tanya Grimaldo
212.257.6515
TGrimaldo@durst.org

Thomas Bow
212.257.6610
TBow@durst.org

AS-BUILT PLAN
ENTIRE FLOOR 19



18,451 SF

Potential Outdoor Space: 1,223 SF

TDO is currently conducting studies to determine location and feasibility of converting setbacks to active terraces.

PRIMARY LEASING CONTACT

Lauren Ferrentino
212.257.6596
LFerrentino@durst.org

ADDITIONAL LEASING CONTACTS

Tanya Grimaldo
212.257.6515
TGrimaldo@durst.org

Thomas Bow
212.257.6610
TBow@durst.org

AS-BUILT PLAN
ENTIRE FLOOR 17



19,832 SF

PRIMARY LEASING CONTACT


Lauren Ferrentino
212.257.6596
LFerrentino@durst.org

ADDITIONAL LEASING CONTACTS

Tanya Grimaldo
212.257.6515
TGrimaldo@durst.org

Thomas Bow
212.257.6610
TBow@durst.org

AS-BUILT PLAN
ENTIRE FLOOR 16

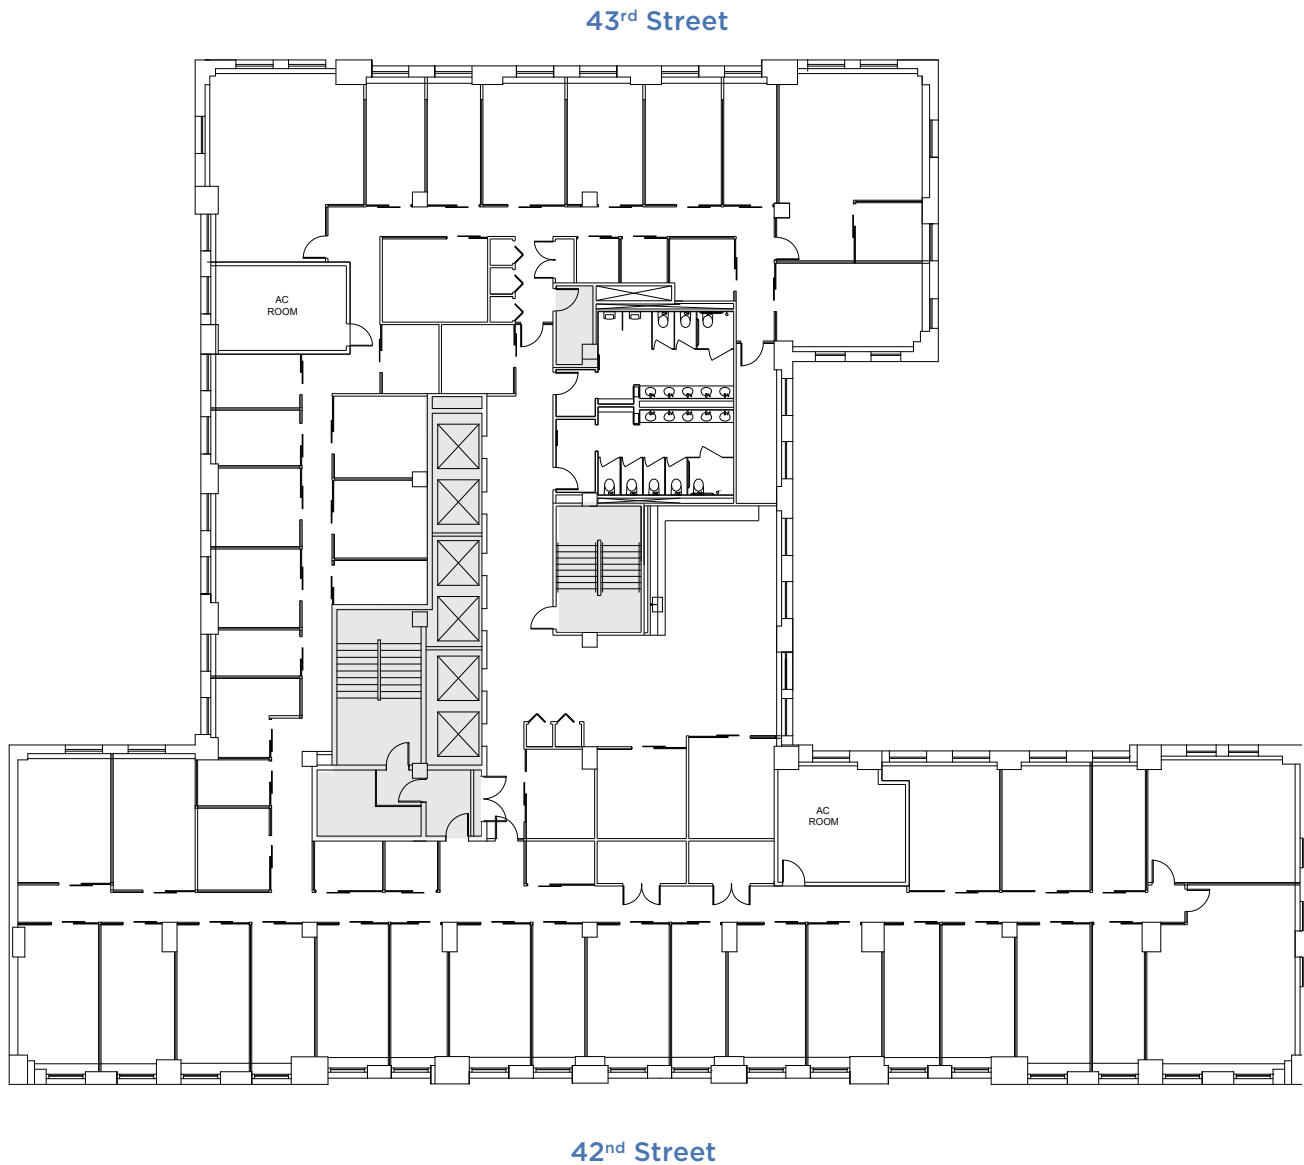

19,832 SF

PRIMARY LEASING CONTACT


Lauren Ferrentino
212.257.6596
LFerrentino@durst.org

ADDITIONAL LEASING CONTACTS

Tanya Grimaldo
212.257.6515
TGrimaldo@durst.org

Thomas Bow
212.257.6610
TBow@durst.org

AS-BUILT PLAN
ENTIRE FLOOR 15

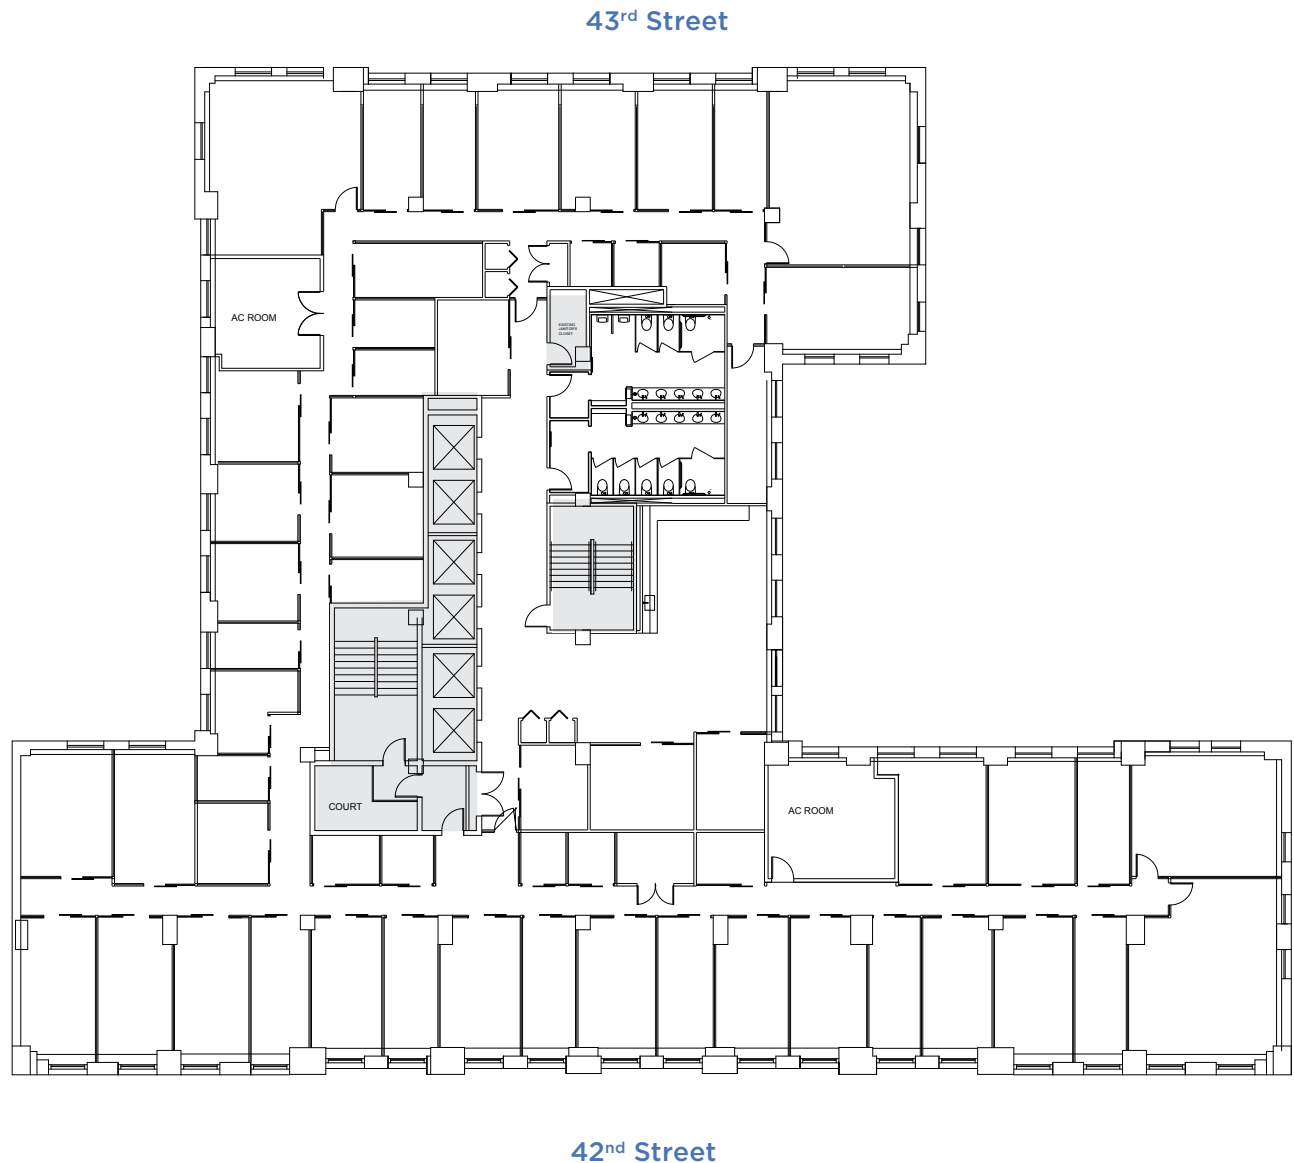

19,832 SF

PRIMARY LEASING CONTACT


Lauren Ferrentino
212.257.6596
LFerrentino@durst.org

ADDITIONAL LEASING CONTACTS

Tanya Grimaldo
212.257.6515
TGrimaldo@durst.org

Thomas Bow
212.257.6610
TBow@durst.org

AS-BUILT PLAN ENTIRE FLOOR 14

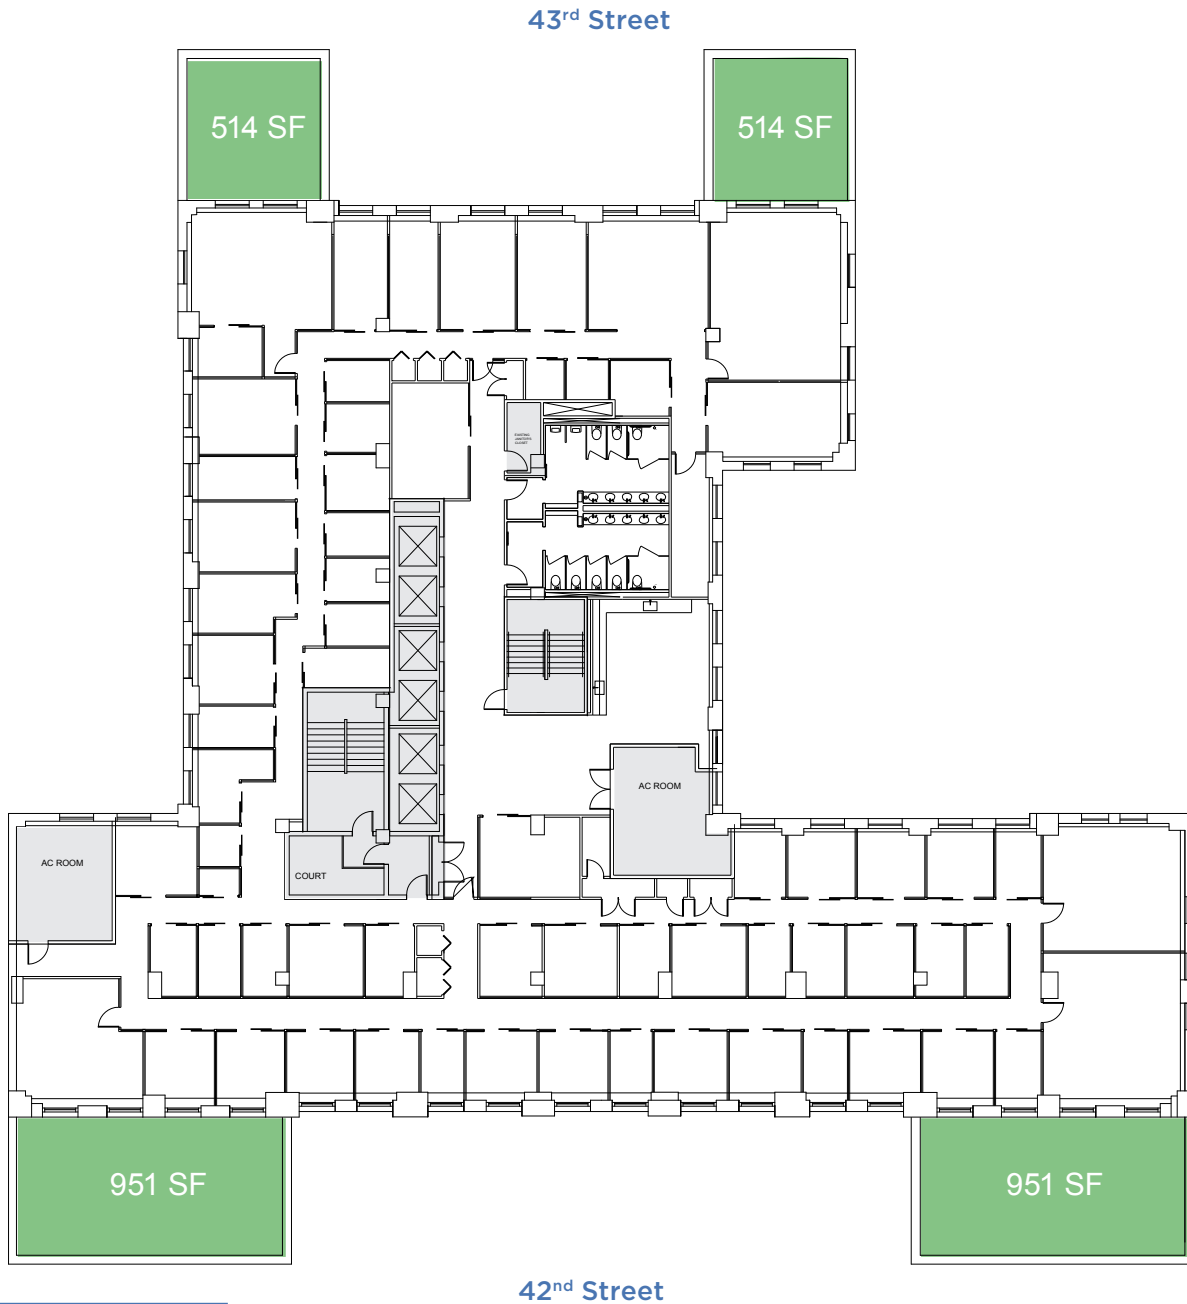

19,831 SF

Potential Outdoor Space: 2,930 SF

TDO is currently conducting studies to determine location and feasibility of converting setbacks to active terraces.

PRIMARY LEASING CONTACT


Lauren Ferrentino
212.257.6596
LFerrentino@durst.org

ADDITIONAL LEASING CONTACTS

Tanya Grimaldo
212.257.6515
TGrimaldo@durst.org

Thomas Bow
212.257.6610
TBow@durst.org

AS-BUILT PLAN
ENTIRE FLOOR 13

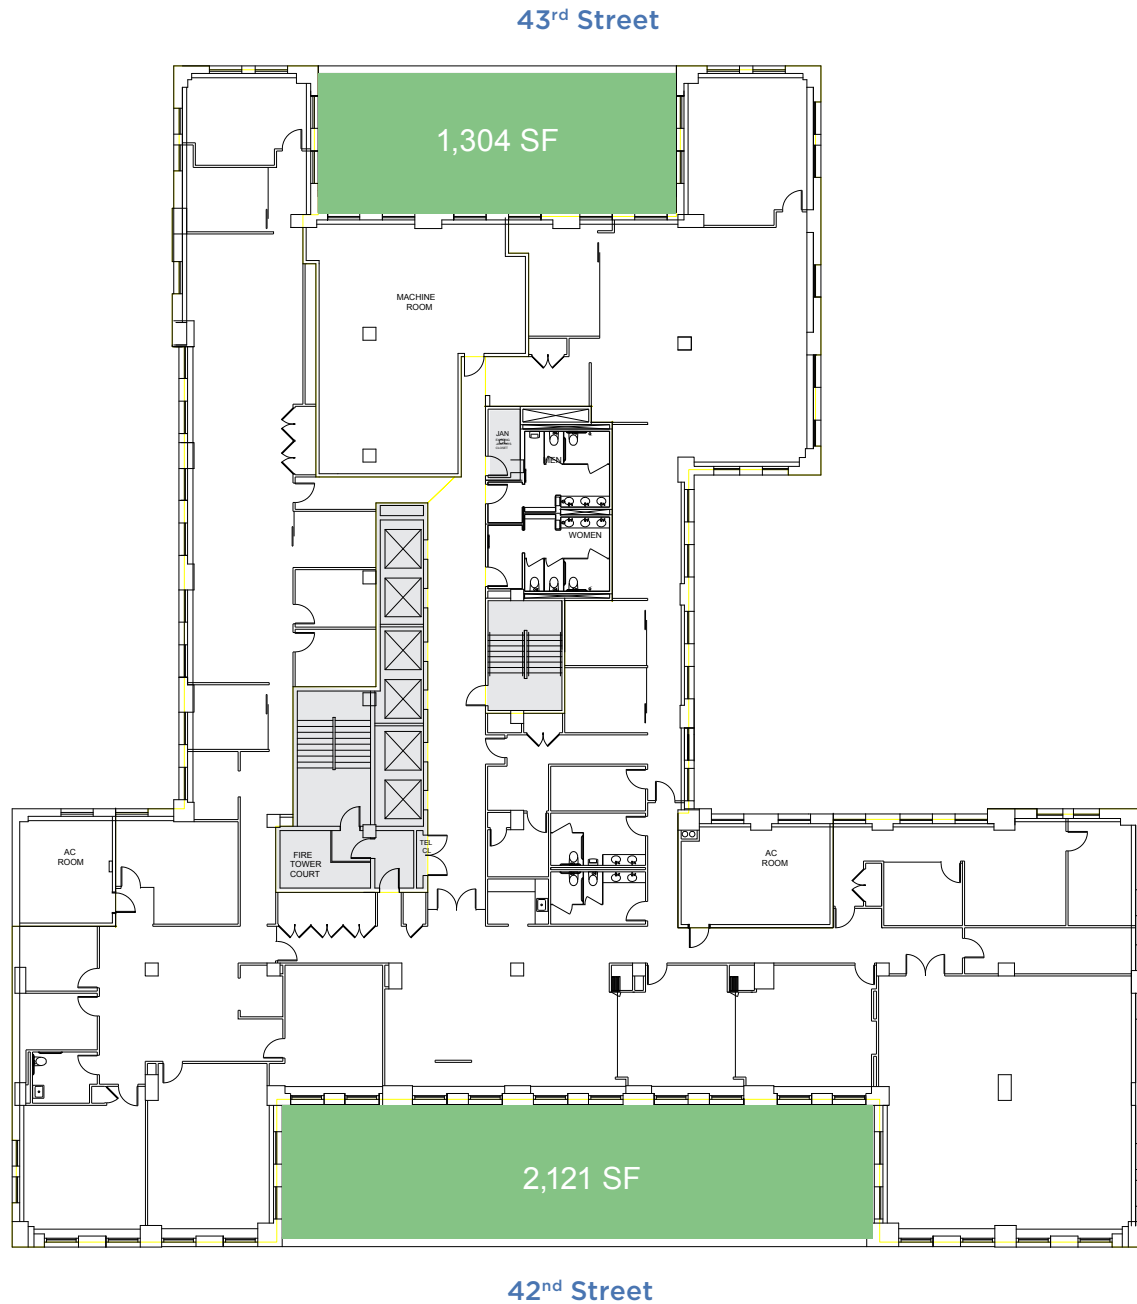

22,264 SF

PRIMARY LEASING CONTACT

Lauren Ferrentino
212.257.6596
LFerrentino@durst.org

ADDITIONAL LEASING CONTACTS

Tanya Grimaldo
212.257.6515
TGrimaldo@durst.org

Thomas Bow
212.257.6610
TBow@durst.org


SAMPLE TEST FIT ENTIRE FLOOR 13

HEADCOUNT

PRIVATE OFFICE	14
BENCHING STATION	83
RECEPTION	1
TOTAL HEADCOUNT	98

GENERAL SPACES

CONF. ROOM / MEETING AREA	12
PANTRY	2
COPY/ STORAGE	1
TELEPHONE ROOMS	6
IT ROOMS	1

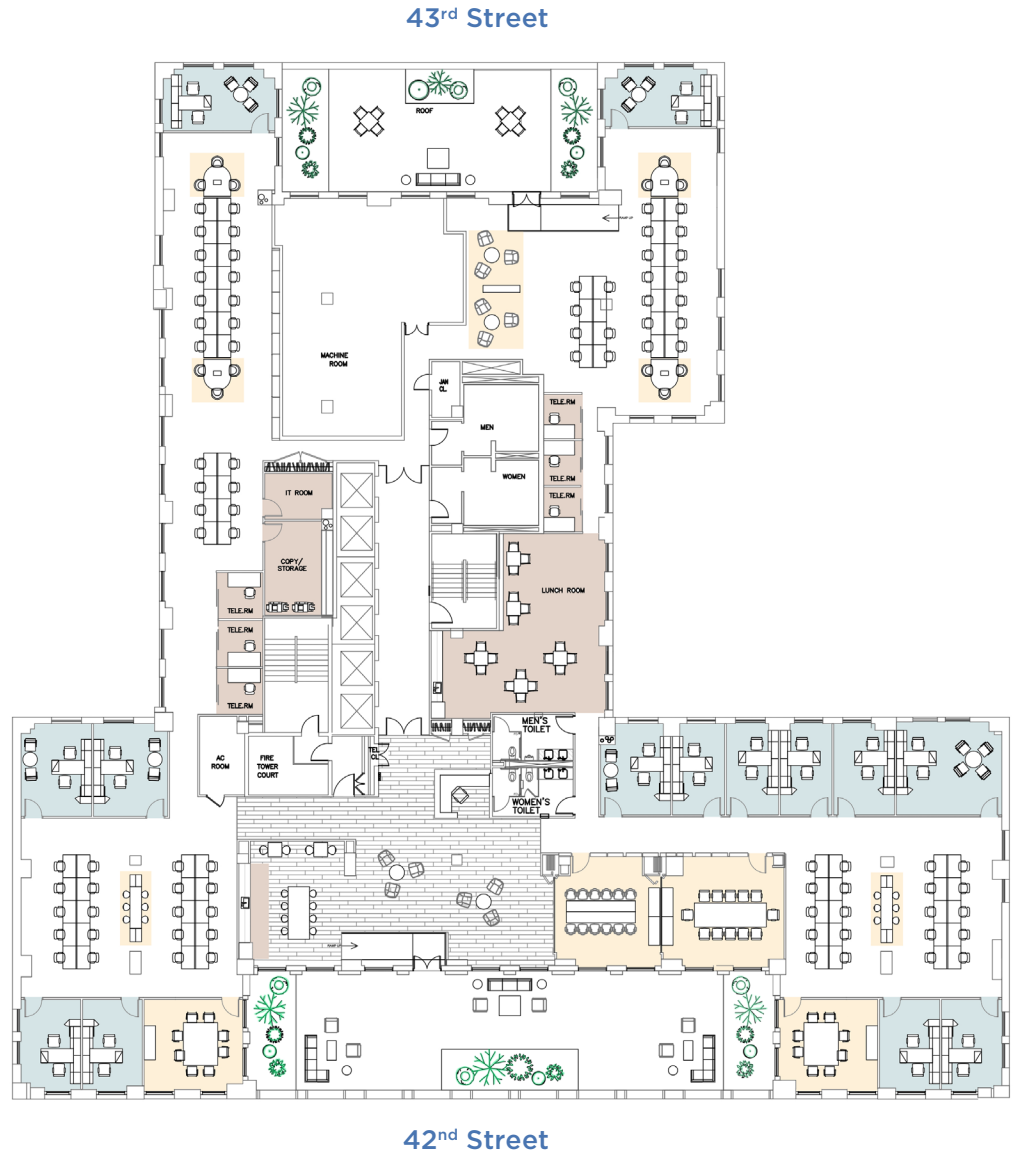

22,264 SF

PRIMARY LEASING CONTACT


Lauren Ferrentino
212.257.6596
LFerrentino@durst.org

ADDITIONAL LEASING CONTACTS

Tanya Grimaldo
212.257.6515
TGrimaldo@durst.org

Thomas Bow
212.257.6610
TBow@durst.org

AS-BUILT PLAN GROUND FLOOR RETAIL

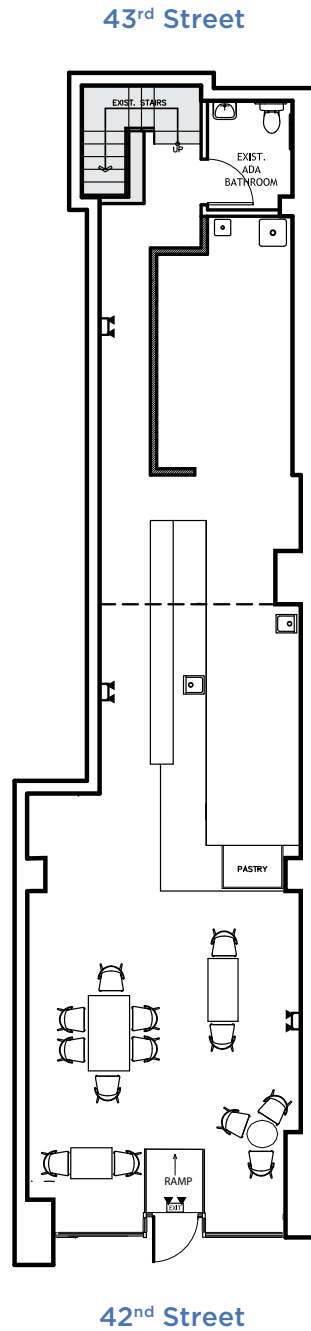

1,242 SF

PRIMARY LEASING CONTACT

Lauren Ferrentino
212.257.6596
LFerrentino@durst.org

ADDITIONAL LEASING CONTACTS

Tanya Grimaldo
212.257.6515
TGrimaldo@durst.org

Thomas Bow
212.257.6610
TBow@durst.org