733 Third Avenue

Entire 8th Floor

Sq. Ft.: 25,438

Type: Office

East 46th Street

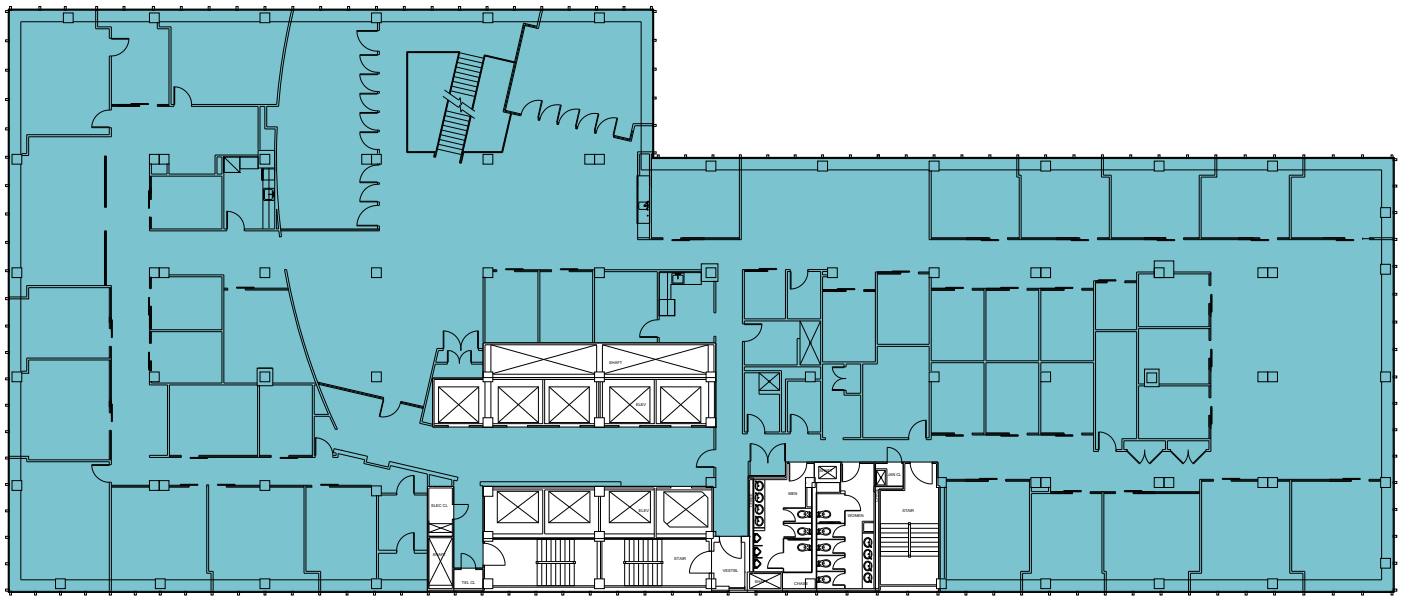

Third Avenue

The Durst Organization
One Bryant Park
New York, NY 10036
212.257.6600

Primary Property Contact:
Ashley Gee
212.257.6596
AGee@durst.org

Leasing Group:
Ashlea Aaron 212.257.6590 AAaron@durst.org
Thomas Bow 212.257.6610 TBow@durst.org